


# AS-BUILT PLANS 12/12/12

11-DEC-2012 13:55

TIME\$\$\$ 006043ER27-1B  
Chad. Havens 8825Full.pen

R:\07400004\006043\GDN\As Bullets\GDN\006043ER27-1B.dgn

STATE	PROJECT NUMBER	SHEET NO.	TOTAL SHEETS
GA	CSNHS-0006-00(043)	630	668

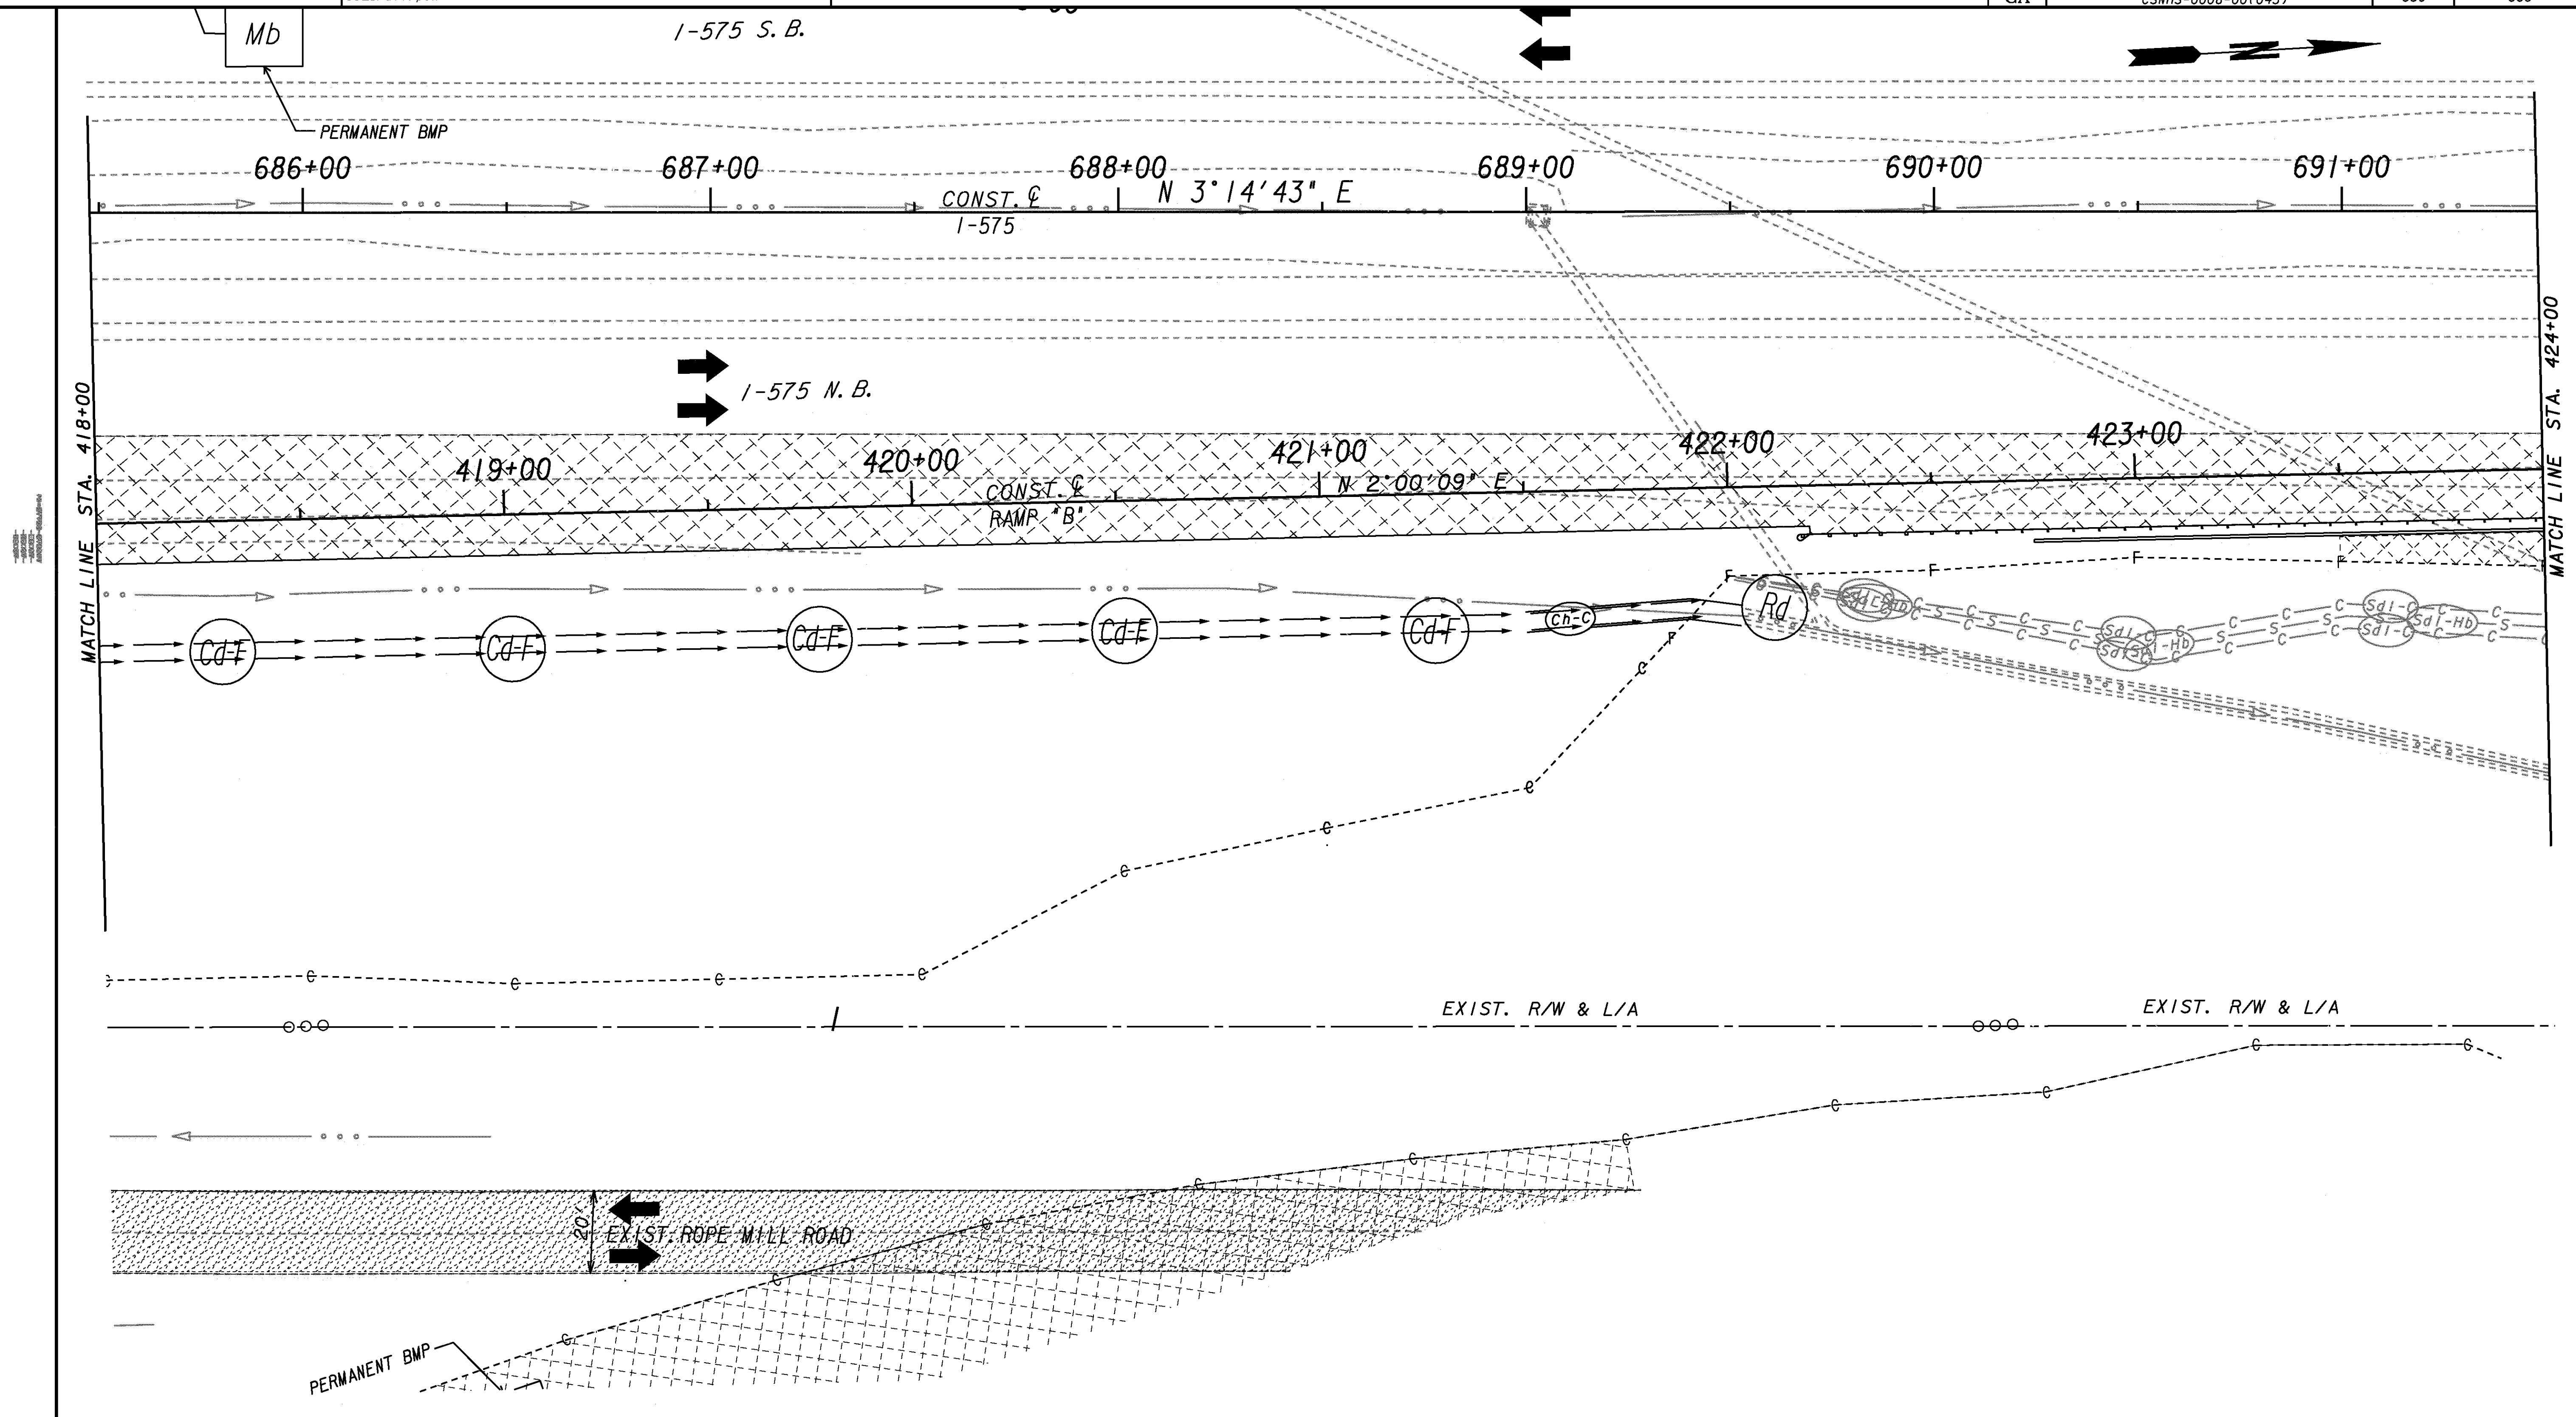

LEGEND

PAVEMENT REMOVAL	
TEMPORARY CONSTRUCTION PAVEMENT	
PERMANENT CONSTRUCTION	
CONCRETE MEDIAN CONSTRUCTION	
MILL & OVERLAY CONSTRUCTION	
OPEN LANES OF TRAFFIC	

THE  
LPA  
GROUP  
TRANSPORTATION CONSULTANTS  
3595 ENGINEERING DRIVE  
NORCROSS, GEORGIA 30092  
(770) 263-9118



REVISION DATES

STATE OF GEORGIA  
DEPARTMENT OF TRANSPORTATION  
OFFICE: INNOVATIVE PROGRAM DELIVERY  
**BMP LOCATION DETAILS**  
INTERMEDIATE PHASE  
I-575 NB ENTRANCE RAMP B  
STA. 418+00 TO STA. 424+00

DRAWING NO.  
54-067